

XJP = DIESEL COMPRESSED AIR SYSTEM

OD = OUTSIDE DIAMETER

PIPELINE NUMBER


2.2 XJN-14-50-6BC1

- PIPING CLASS
- DIAMETER NOMINAL (SIZE)
- RUNNING NO.:
- FLUID
- REDUNDANCE

Rev.	Art der Änderung Description of Revisions	Datum Date	Gez. Made	Gepr. Ch'd	Freigegeben App'd
m	SS built com.	20.7.00	BAB	Kudde	Fr
L	XJN01 CH001 new	04.7.89	BAB	ges. Stapel	W. Lehmann
K	Revised	7.2.92	Babacan	Görzig	
J	REVISED KWU-No. AND Δ	10.7.84	Lehmann	W. Lehmann	
i	REVISED, COMPL. AND DRWG. NO. 740 03170 G CHANGED	27.04.83	ULSP	W. Lehmann	
h	REVISED AND DRWG. NO. 4E 19K 3596E CHANGED	15.03.82	Wirling, F	W. Lehmann	

ÄNDERUNGEN REVISIONS

XG/ 2.2 XJN 01/001

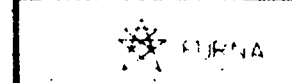


KWU ANGRA II, BUILDING UBP (D1)

Gepr. Name	Wirling, F
Datum	15.03.82
Gepr. Name	W. Lehmann
Datum	03.05.83

KHD Engineering GmbH

FUEL OIL DIAGRAM
DIESELKRAFTSTOFF SCHEMA

4E 19K 3596E/2.2

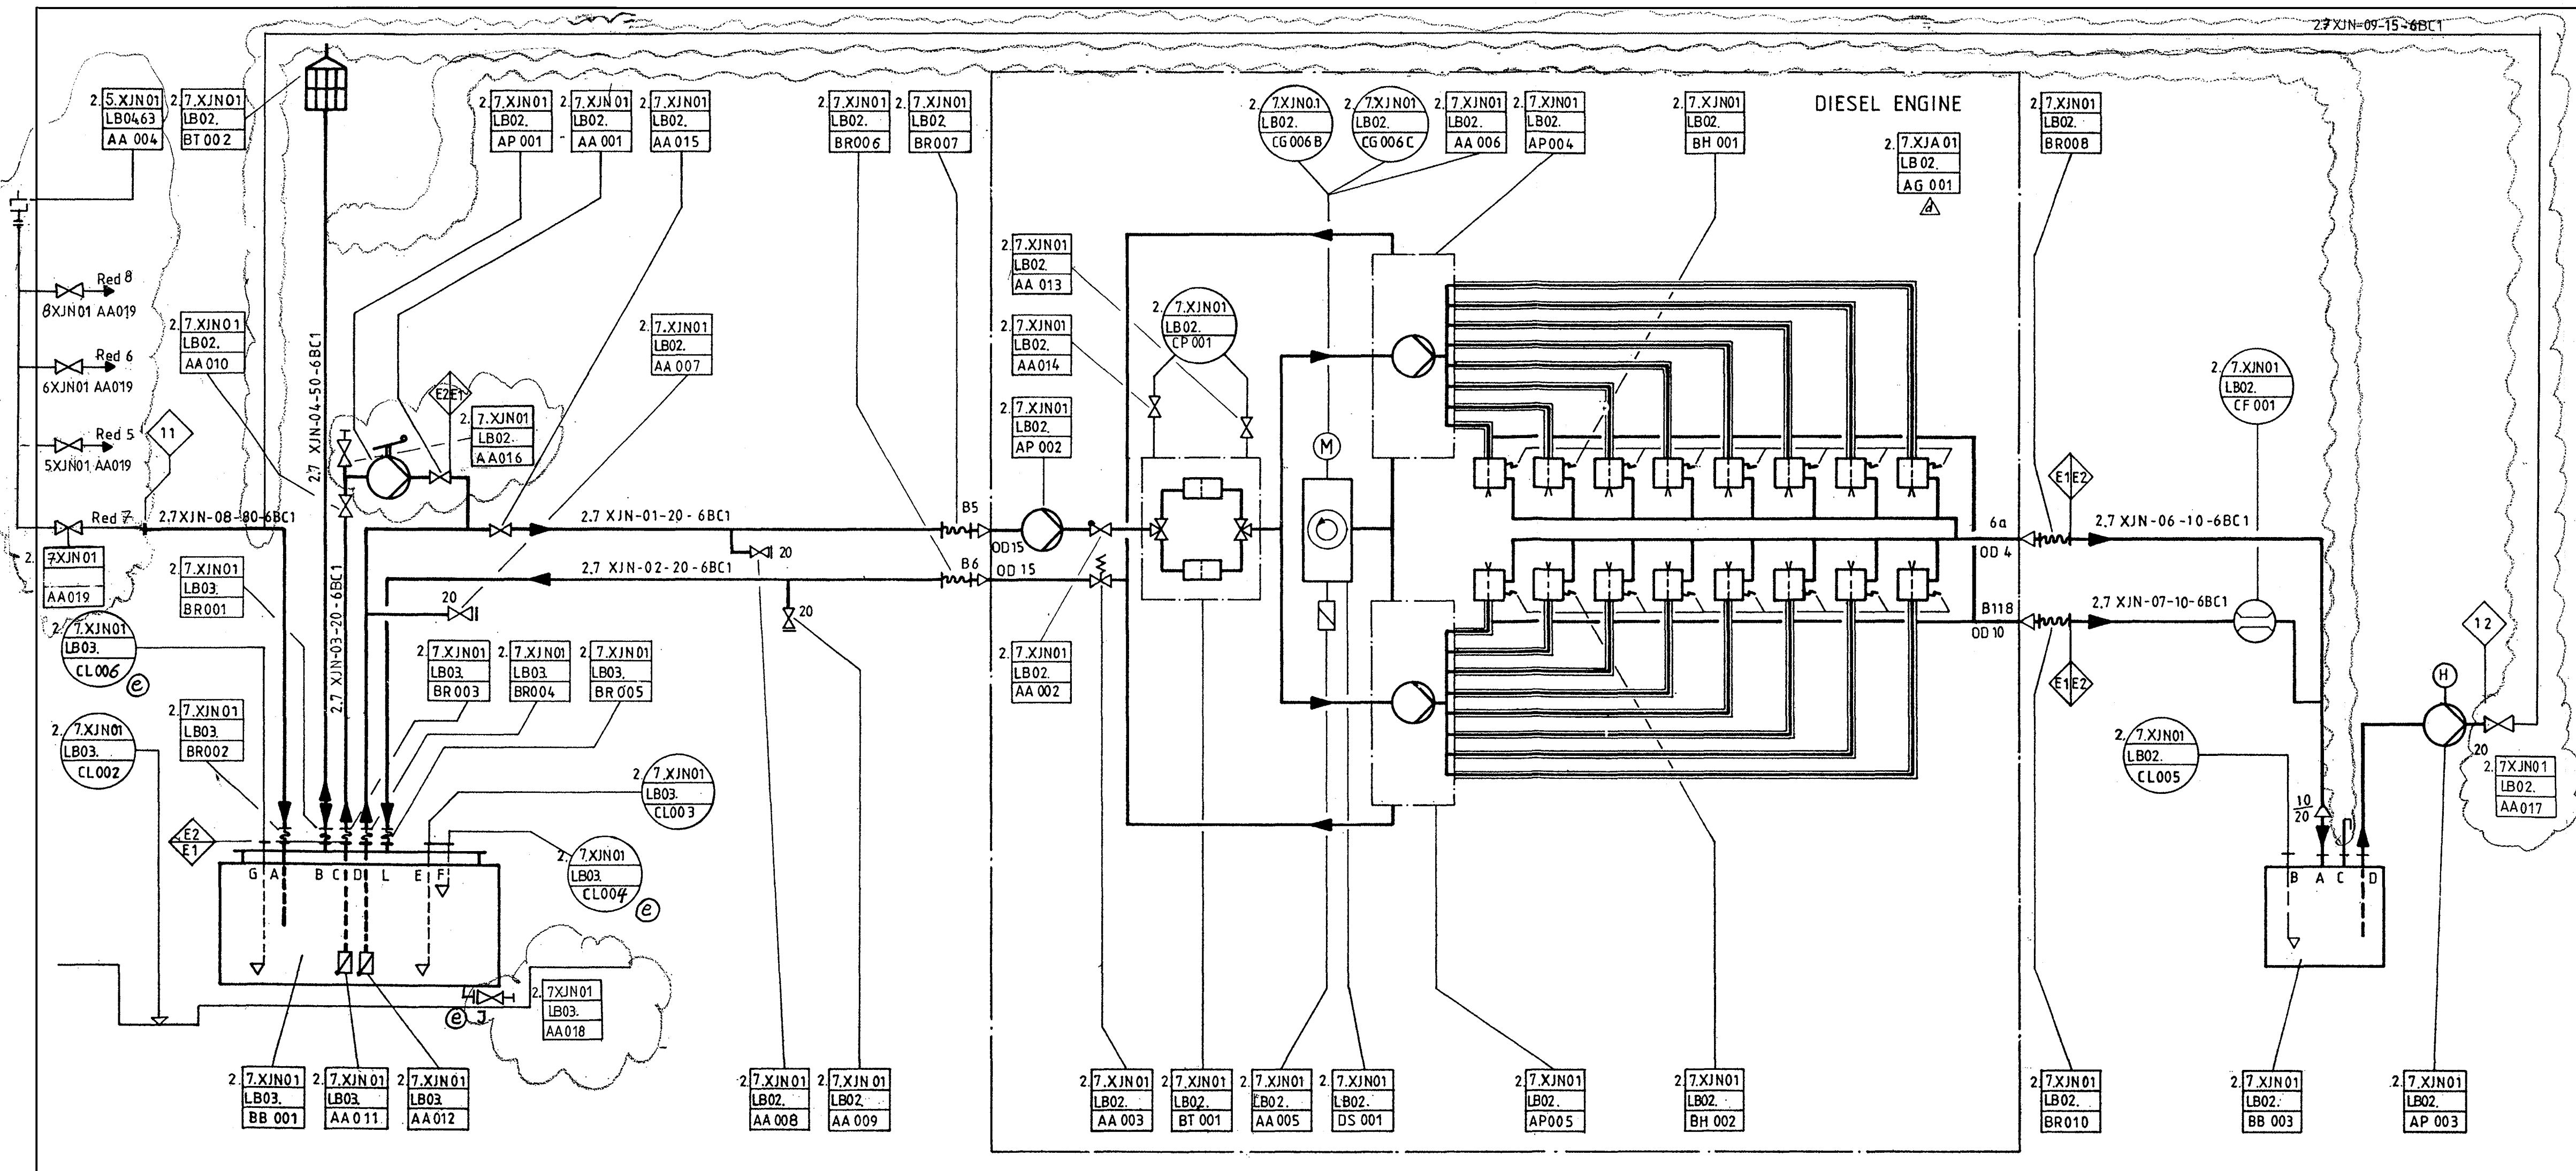

OD = OUTSIDE DIAMETER
 PIPELINE NUMBER
 2.7 XJN-02-40-6BC1

— PIPING CLASS
 — DIAMETER NOMINAL (SIZE)
 — RUNNING NO.:
 — FLUID
 — REDUNDANCE

Rev.	Art der Änderung Description of Revisions	Datum Date	Gez. Made	Gepr. Ch'd	Freigeg. App'd
f	as built com.	04.07.00	Ba	Tholla	
e	Revised @	30.10.92	Babacan	Görzig	
d	REVISED KWU - NR ANDA	12.2.84	Huh	Ulsperger	
c	DRAWING COMPLETED AND REVISED	3.1.84	Stark		
b	COMPLETED	23.06.83	ULSPERGER		
a	REVISED AND DRWG.NO.: 4E19K 3708 E CHANGED	30.04.82	Wirling, J	Liska	

ÄNDERUNGEN REVISIONS					
XG/ 2.7 XJN 01/001					
Kunde und Kennwort Client and Code Word: KWU ANGRA II, BUILDING ULB (D2)					

Gezeichnet: Made:	Datum Date	Name Name	 KHD Engineering GmbH
Geprüft: Checked:	30.04.82	Wirling, J	
Freigeg. Approved:	14.6.83	Liska	
Maßstab Scale	Zeichnungs Nr. Drawing No.:		FUEL OIL DIAGRAM DIESELKRAFTSTOFF SCHEMA
			740 03360-G/2.7

Export Classification: All goods labeled with "A" not equal to "N" are subject to European or German export authorisation when being exported out of the EU. Goods labeled with "ECN" are equal to "N" and do not require export authorisation. For more information, please refer to the ECN or "A" label. All ECN or "A" labels must be clearly visible on the goods and must not be obscured or removed. For more information, please refer to the ECN or "A" label.